RACK SCHEDULE

RACK I.D.	RACK TYPE	UPRIGHT HEIGHT	BAR HEIGHT
L	1	15'	15'-0"
M	3	20'	15'-4"
D	2A	16'	15'-4"
B	2	16'	15'-6"
A	2	16'	15'-6"
C	2	16'	15'-6"
AS-1-9	3	20'	15'-4"
AS-10-40	2A	16'	15'-4"
G 1-5	2A	16'	15'-4"
G 6-16	2	16'	15'-6"
J	3	20'	15'-4"
E	3	20'	15'-4"
F	3	20'	15'-4"
KA	2B	16'	16'-0"
OUTBOUND	2	16'	15'-6"

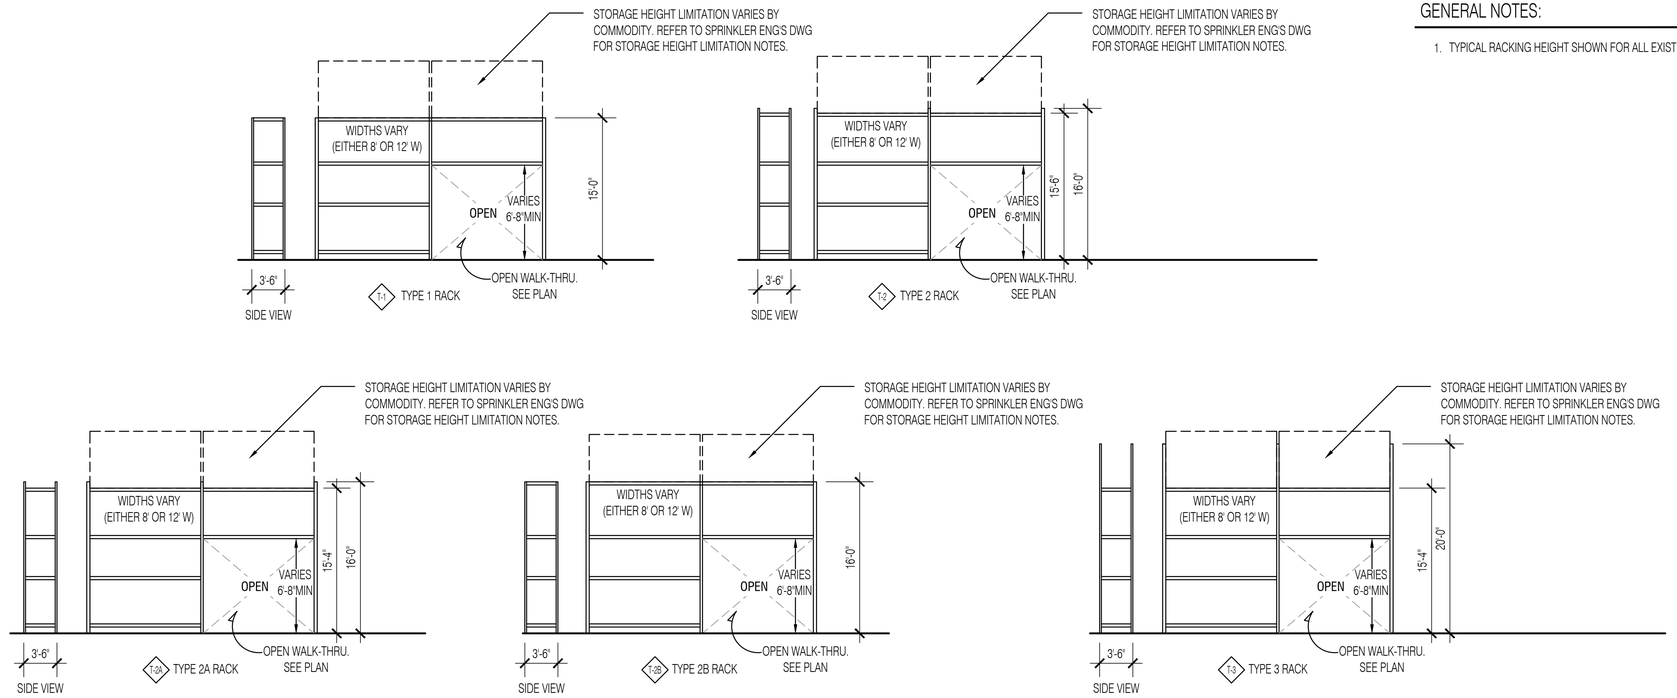

GENERAL NOTES:

1. TYPICAL RACKING HEIGHT SHOWN FOR ALL EXISTING RACKING.

2 EXISTING RACKING LAYOUT: TYPICAL RACK ELEVATION

SCALE: 1/8"=1'-0" (IF 11X17 SCALE= 1/16"=1'-0")

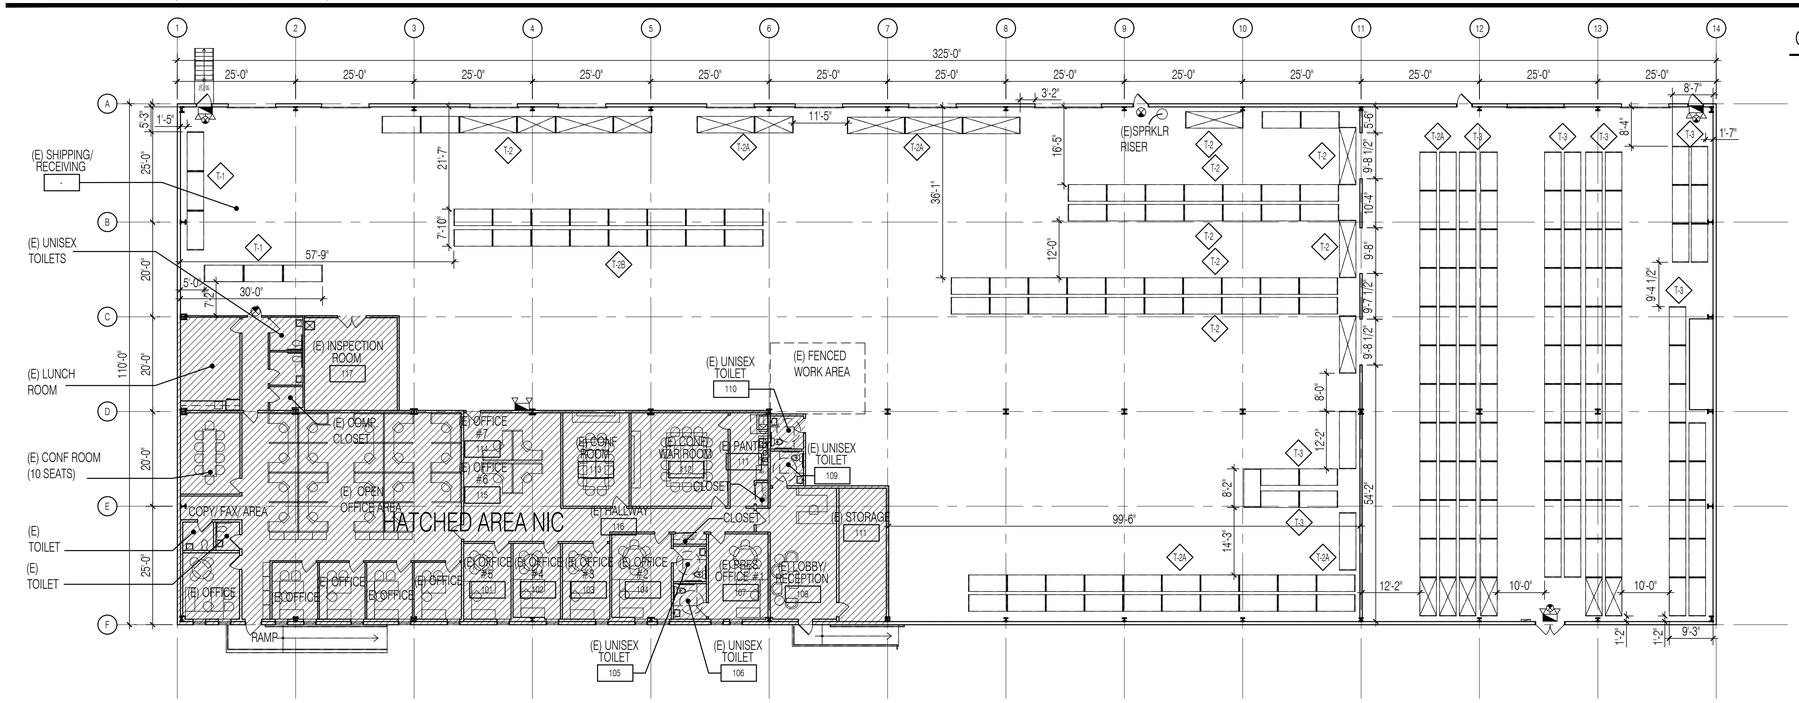

GENERAL NOTES:

1. REFER TO ALL APPLICABLE CODES AND NOTES ON SHEET A0.00 THRU A0.01.
2. EXISTING RACKING LAYOUT SHOWN IS BASED ON ASBUILT SURVEY CONDUCTED BY THIS OFFICE.
3. REFER TO CEILING PLAN AND PROVIDE ADDITIONAL LIGHTS, EXIT SIGNS AND EMERGENCY LIGHTS.
4. REFER TO SPRINKLER ENGINEER'S DRAWINGS FOR MODIFICATIONS TO EXISTING SPRINKLER SYSTEM REQUIRED TO ACCOMMODATE THE EXISTING RACKING LAYOUT.

LEGEND:

- EXISTING DOOR
- ROOM NAME / 001 — ROOM TAG
- 8 FT RACK
- 12 FT RACK
- RACKS W/ WALK THRU AT GROUND LEVEL

1 EXISTING RACKING LAYOUT: FIRST FLOOR PLAN

SCALE: 1/16"=1'-0" (IF 11X17 SCALE= 1/32"=1'-0")

PROJECT

Brighton Cromwell Warehouse Existing Racking Layout Study

PROJECT LOCATION

111 Canfield Ave, Building C
Randolph, New Jersey 07869

CLIENT

Brighton Cromwell
111 Canfield Ave, Building C
Randolph, New Jersey 07869

ARCHITECT

BEN HORTEN architecture & design
312 State Route 10, Randolph, NJ 07869
Tel: 973.442.5880 Fax: 973.442.5886

CONSULTANT

Issues and Revisions

No.	Date	Issues and Revisions	By	Check
1.	11/01/18	ISSUE FOR PERMIT	CG	BH

Registration and Signature

Benjamin J. Horten, AIA NJ LICENSE # 21AI 15794

Drawing Description:
EXISTING RACKING LAYOUT: FIRST FLOOR PLAN

Computer File:
L:\18182_Brighton Cromwell-fire code violation\drawings\3 CD update\plan_01.dwg

A2.01

All drawings and written material appearing herein constitute original and unpublished work of the architect and may not be duplicated, used or disclosed without written consent of the architect.
©2018 BEN HORTEN ARCHITECTURE & DESIGN All Rights Reserved